

BLACK HORSE PIKE REGIONAL SCHOOL DISTRICT
Highland HS 2025 LMC Corridor & Classroom Renovations (GA# 23-73)
Addendum #1– Cover Sheet
January 9, 2025

Bid Package Clarification and Changes

This Addendum dated January 9, 2025 for the **Highland HS 2025 LMC Corridor & Classroom Renovations** shall be included as part of the Contract Bid Documents. This Addendum shall supplement and clarify the current Contract Bid Documents.

ADDENDUM #1 CONSISTS OF ALL OF THE ITEMS LISTED BELOW.

1. Addendum #1 – Narrative (3 pages)
2. Contractor Questions and Answers (2 pages)

3. Sketch ADM-1.01 (1 sketch)
4. Sketch ADM-1.02 (1 sketch)
5. Sketch ADM-1.03 (1 sketch)
6. Sketch ADM-1.04 (1 sketch)

One (1) full size drawing of each of the following are included in this Addendum with an Addendum #1 Revision Date of January 9, 2025

7. Drawing M1.1
8. Drawing M1.1A
9. Drawing M2.1
10. Drawing M2.1A
11. Drawing M4.1

PLEASE ACKNOWLEDGE RECEIPT OF THIS ENTIRE ADDENDUM BY SIGNING BELOW AND EMAILING BACK IMMEDIATELY TO jminniti@garrisonarch.com. If this information is unclear, please call (856) 396-6200. If you are not bidding this project, please write "No Bid" and send this page back.

Signature

Company

Highland HS 2025 LMC Corridor & Classroom Renovations (GA# 23-73)

BLACK HORSE PIKE REGIONAL SCHOOL DISTRICT
Highland HS 2025 LMC Corridor & Classroom Renovations (GA# 23-73)
Addendum #1 - Narrative
January 9, 2025

SPECIFICATIONS

1. In Specification Section Summary of Work 01010 **DELETE** Section 01010.1.1E.3 in its entirety and **REPLACE** with the following
 - a. The **On-Site Construction** period, during which all work on site is to be performed, is to start on **April 18, 2025**. This is the start of Spring Recess which runs from April 18, 2025 thru April 27, 2025. Students and Staff will return on Monday, April 28, 2025. The intent during the Spring Recess period is for the Contractor to construct a new GWB and metal stud partition wall and associated ceiling work for the new Corridor which is adjacent to the LMC space. The new wall shall be taped, spackled, sanded and painted with new base on the LMC side only (Base Bid). If Alternate #1 is accepted, the Contractor shall construct an additional new GWB and metal stud partition wall as shown on the documents and associated ceiling work. The wall(s) will separate the LMC space from the proposed work area and will allow for the Contractor to work while school is in session for the remainder of the school year (from 4/28/25 to on or about 6/20/25). **NO WORK can begin in the work area until the new partition wall(s) is in place.** Any work that needs to be done on the LMC side of the partition(s) while school is in session will need to be done on second shift or with special arrangements and written approval by the Owner. On May 20, 2025 and May 21, 2025 there will be testing taking place in the LMC in the morning, therefore NO WORK can take place in the work area until after dismissal time of 12:30 p.m. on those days. Upon completion of the school year (on or about 6/20/25) the Contractor will have full access to the LMC space to complete the remaining work which must be completed on or before August 1, 2025.
2. The **ATTACHED** “Addendum #1 - Contractor Questions and Answers” shall be considered as part of this Addendum #1. **(2 Pages)**

DRAWINGS

ARCHITECTURAL

1. On Drawing A-0:
 - a. **REVISE** Drawing as per the **ATTACHED Sketch ADM-1.01 (1 Sketch)**.
 - b. **REVISE** Drawing as per the **ATTACHED Sketch ADM-1.02 (1 Sketch)**.
2. On Drawing A-0.1:
 - a. **REVISE** Drawing as per the **ATTACHED Sketch ADM-1.03 (1 Sketch)**.
 - b. **REVISE** Drawing as per the **ATTACHED Sketch ADM-1.04 (1 Sketch)**.
3. On Drawing A-1: At detail 1/A-1 Existing/Demolition Floor Plan – Base Bid **REVISE** per the following:

- a. In Literacy Lab C100G on the north wall the Owner shall **REMOVE** the existing Smartboard and track system and the Contractor shall **REMOVE** the 10' whiteboard and patch and prep the entire wall to receive new finishes per the room finish schedule.
 - b. In Literacy Lab C100G on the south wall the Contractor shall **REMOVE** the existing 12' tackboard and patch wall to receive new finishes per the room finish schedule.
 - c. In Computer Resource C100H on the east wall the Contractor shall **REMOVE** the existing clock/speaker and infill opening with CMU to match and prep wall to receive new finishes per the room finish schedule.
4. On Drawing A-1: At detail 2/A-1 Existing/Demolition Floor Plan – Alternate Bid **REVISE** per the following:
 - a. In Office C100F on the west wall the Owner shall **REMOVE** the wall mounted projector and speakers and the Contractor shall **REMOVE** the existing 6' whiteboard and patch and prep wall to receive new finishes per the room finish schedule.
 - b. In Office C100F on the south wall the Contractor shall **REMOVE** the existing 12' whiteboard and patch wall to receive new finishes per the room finish schedule.

MECHANICAL

1. Drawings M1.1: **DELETE** Drawing in its entirety and **REPLACE with the ATTACHED** Drawing M1.1 ISSUED FOR ADDENDUM #1: 1/9/25 (1 Full Size Drawing).
2. Drawings M1.1A: **DELETE** Drawing in its entirety and **REPLACE with the ATTACHED** Drawing M1.1A ISSUED FOR ADDENDUM #1: 1/9/25 (1 Full Size Drawing).
3. Drawings M2.1: **DELETE** Drawing in its entirety and **REPLACE with the ATTACHED** Drawing M2.1 ISSUED FOR ADDENDUM #1: 1/9/25 (1 Full Size Drawing).
4. Drawings M2.1A: **DELETE** Drawing in its entirety and **REPLACE with the ATTACHED** Drawing M2.1A ISSUED FOR ADDENDUM #1: 1/9/25 (1 Full Size Drawing).
5. Drawings M4.1: **DELETE** Drawing in its entirety and **REPLACE with the ATTACHED** Drawing M4.1 ISSUED FOR ADDENDUM #1: 1/9/25 (1 Full Size Drawing).

ELECTRICAL

1. On Drawing 1/E1: **RELOCATE** pull station (door is getting wider) in Corridor outside existing Literacy Lab C100G.
2. On Drawing 2/E1: **CHANGE** switch in IDF room to wireless dimmer switch.
3. On Drawing 2/E1: **ADD** one additional occupancy sensor to Classroom C105 and Classroom C106.
4. On Drawing 2/E2: The three way switch shall be compatible with wireless lighting control relay.

5. On Drawing 1/E2: If the Alternate is accepted, the Owner will **REMOVE** and **RELOCATE** the wiring for the Copy Machine, CO-EX.
6. On Drawing 2/E2: **ADD** one additional occupancy sensor to Classroom C108.
7. On Drawing 1/E4: **CHANGE** DOAS-1A in Single Line Diagram to DOAS-1.
8. General Note: Clock and Speaker Vendor is Eastern Datacomm (Marylou Wallner mwallner@easterndatacomm.com).
9. General Note: Fire Alarm Vendor is Jim Minnick (856-318-9637, mfssystems@makofiresecurity.com).

BLACK HORSE PIKE REGIONAL SCHOOL DISTRICT
Highland HS 2025 LMC Corridor & Classroom Renovations (GA# 23-73)
Addendum #1 – Contractor Questions and Answers

Levy Construction 12-20-24

- 1) Please advise who the current fire alarm provider.

Answer: MFS Sysytems
mfssystems@makofiresecurity.com
Jim Minnick, 856-318-9637

- 2) Please provide who the electronic clock provider.

Answer: Eastern DataComm
mwallner@easterndatacomm.com
Marylou Wallner

Russo Corp. 12-27-24

- 1) Do permit fees actually apply to this project, or will the municipality waive permitting fees for this project? Often with public projects, the fees are waived by the township.

Answer: See Specification Section 01010.1.1.K

- 2) I noticed the below passage from p. 192 of the bid specs pdf, which I highlighted in yellow 3 (Section 01500 Part 1.3 Execution Paragraph G Item #2). Can you please confirm whether this contract will REQUIRE the contractor to provide an onsite job trailer, or is it optional?

Answer: No onsite job trailer is required.

Levy Construction 12-31-24

- 1) Please advise when you anticipate the demolition of the alternate bid scope of work to take place, if alternate # 1 is accepted.

Answer: See revision of Specification Section 01010.1.1.E.3 in the Addendum #1 Narrative.

Levy Construction 01-02-25

- 1) Who is the current BMS contractor for the school?

Answer: See Specification Section 15930.1.01.2

- 2) On M1.1 and M1.1a demo prints there are some missing branch duct sizing needed for patch work (mech sheet note #3). The CFM information is missing for (mech sheet note 5) on several of the GRD's. Needed to rebalance. I also need the existing GRD's CFM for rebalancing as called out in note 5.

Answer: Please see Addendum Narrative for answer.

- 3) Please provide duct sizes for the DOAS unit duct drops and elevation print, with duct height listed.

Answer: Duct openings are full size of unit openings. Elevations are to be verified in the field.

- 4) Is there a time/date for subcontractors to re-visit the site?

Answer: See Specification Section 01010 Summary of Work. Site visits can be arranged through Rob Mortka, the cell number is (609) 929-8141, office number is (856) 227-4100 ext. 4009.

Russo Corp. 01-06-25

- 1) Who is the existing fire alarm vendor?

Answer: See answer above. (Levy Construction – 12-20-24 #1)

- 2) Who is the existing clock/speaker vendor?

Answer: See answer above. (Levy Construction – 12-20-24 #2)

Straga Brothers 01-06-25

- 1) Please confirm there is no Plumbing work required within the project.

Answer: The project will have plumbing work. Please see Drawing M1.1 Re-Issued for Addendum #1:01-09-25.

USA Electric 01-06-25

- 1) The name and phone number of the service company for the PA system?

Answer: See answer above. (Levy Construction – 12-20-24 #2)

- 2) Will the [3] classroom ceiling speakers shown on electrical plans need to go back to PA headend individually or can they all connect to corridor speakers?

Answer: Coordinate with the District's vendor.

- 3) Can the new corridor speakers connect to either the existing circuit that fed library demo speakers or connect to existing corridor outside of construction area?

Answer: Coordinate with the District's vendor.


- 4) Can the new clocks in classrooms be connected to existing clock circuits adjacent to the work area?

Answer: Coordinate with the District's vendor.

Joseph Porretta Builders 01-07-25

- 1) Is there any on site testing of materials, from a licensed testing agency, for structural steel and masonry required for this project?

Answer: No.

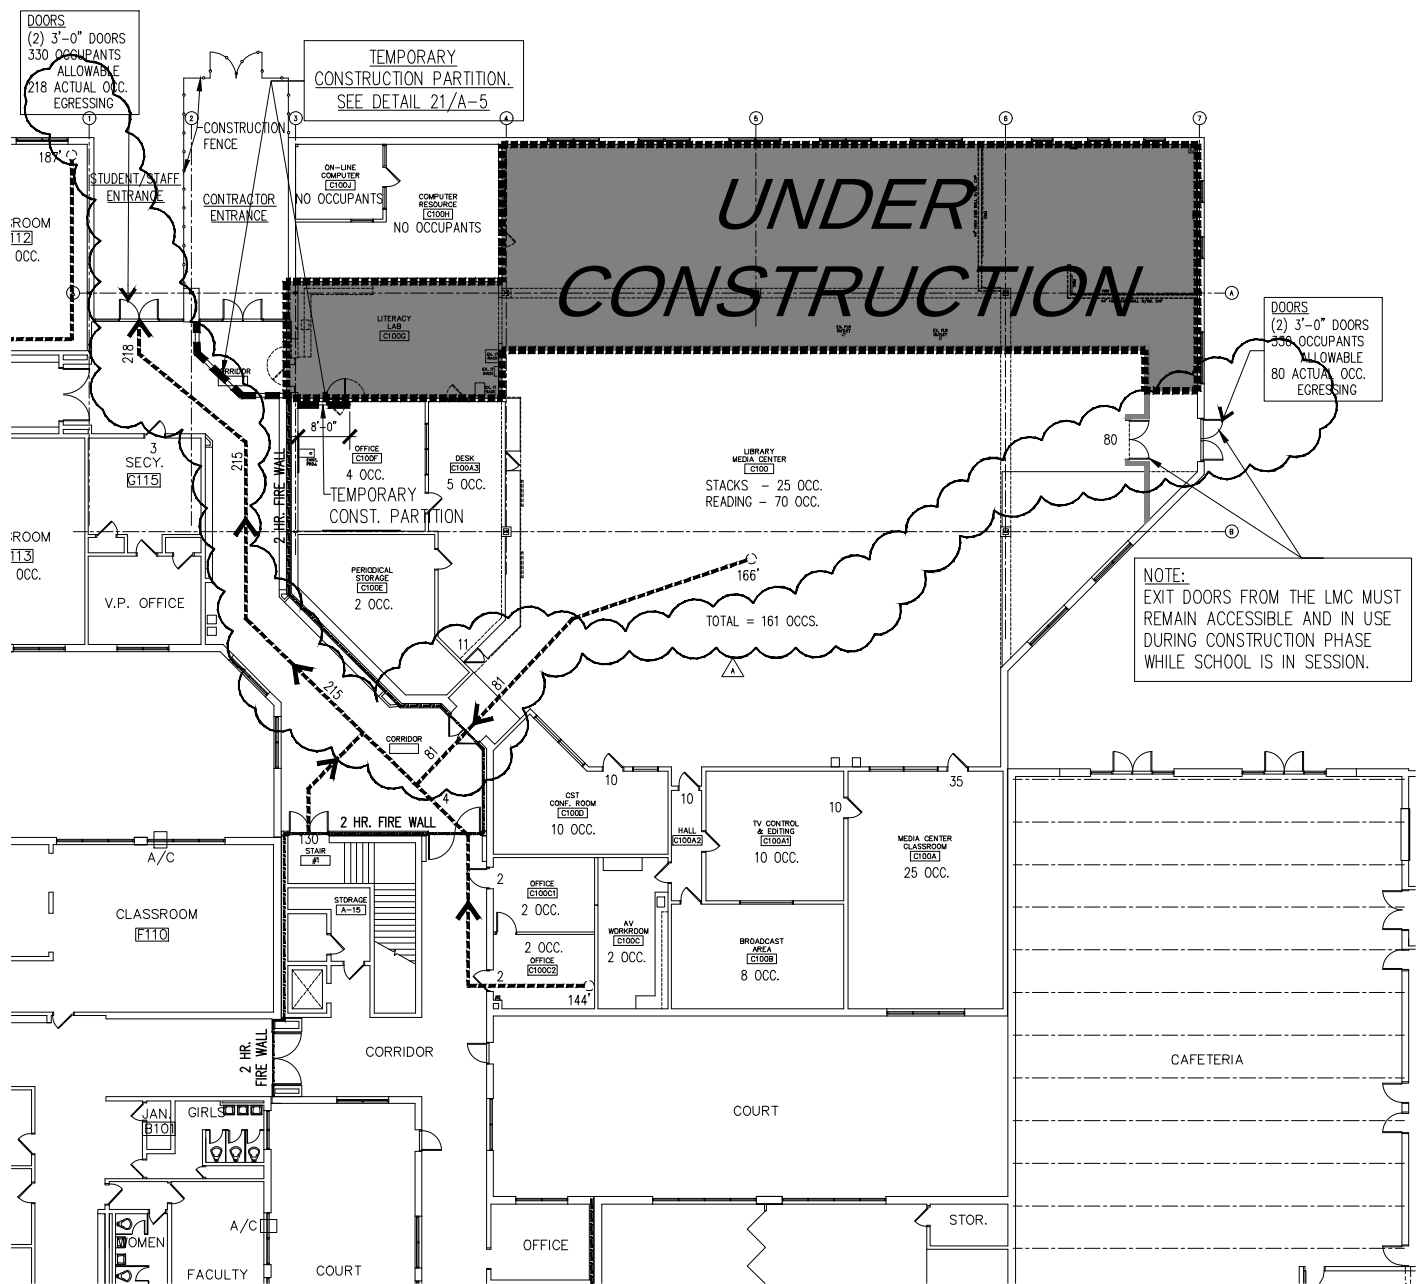

1 EGRESS FLOOR PLAN - BASE BID - CONSTRUCTION PHASE (DURING SCHOOL YEAR) - 4/28/25 THRU 6/20/25
A-0 SCALE: 1/16" = 1'-0"



**GARRISON
ARCHITECTS**


A Professional Corporation of Architects and Planners
713 CREEK ROAD, BELLMAWR, NEW JERSEY 08031 (856) 396-6200

PROJECT NAME:
HIGHLAND REGIONAL HIGH SCHOOL
2025 LMC NEW CORRIDOR &
CLASSROOMS RENOVATIONS

PROJECT NUMBER:
23-73

DATE: 01/09/25

ADM-1.01

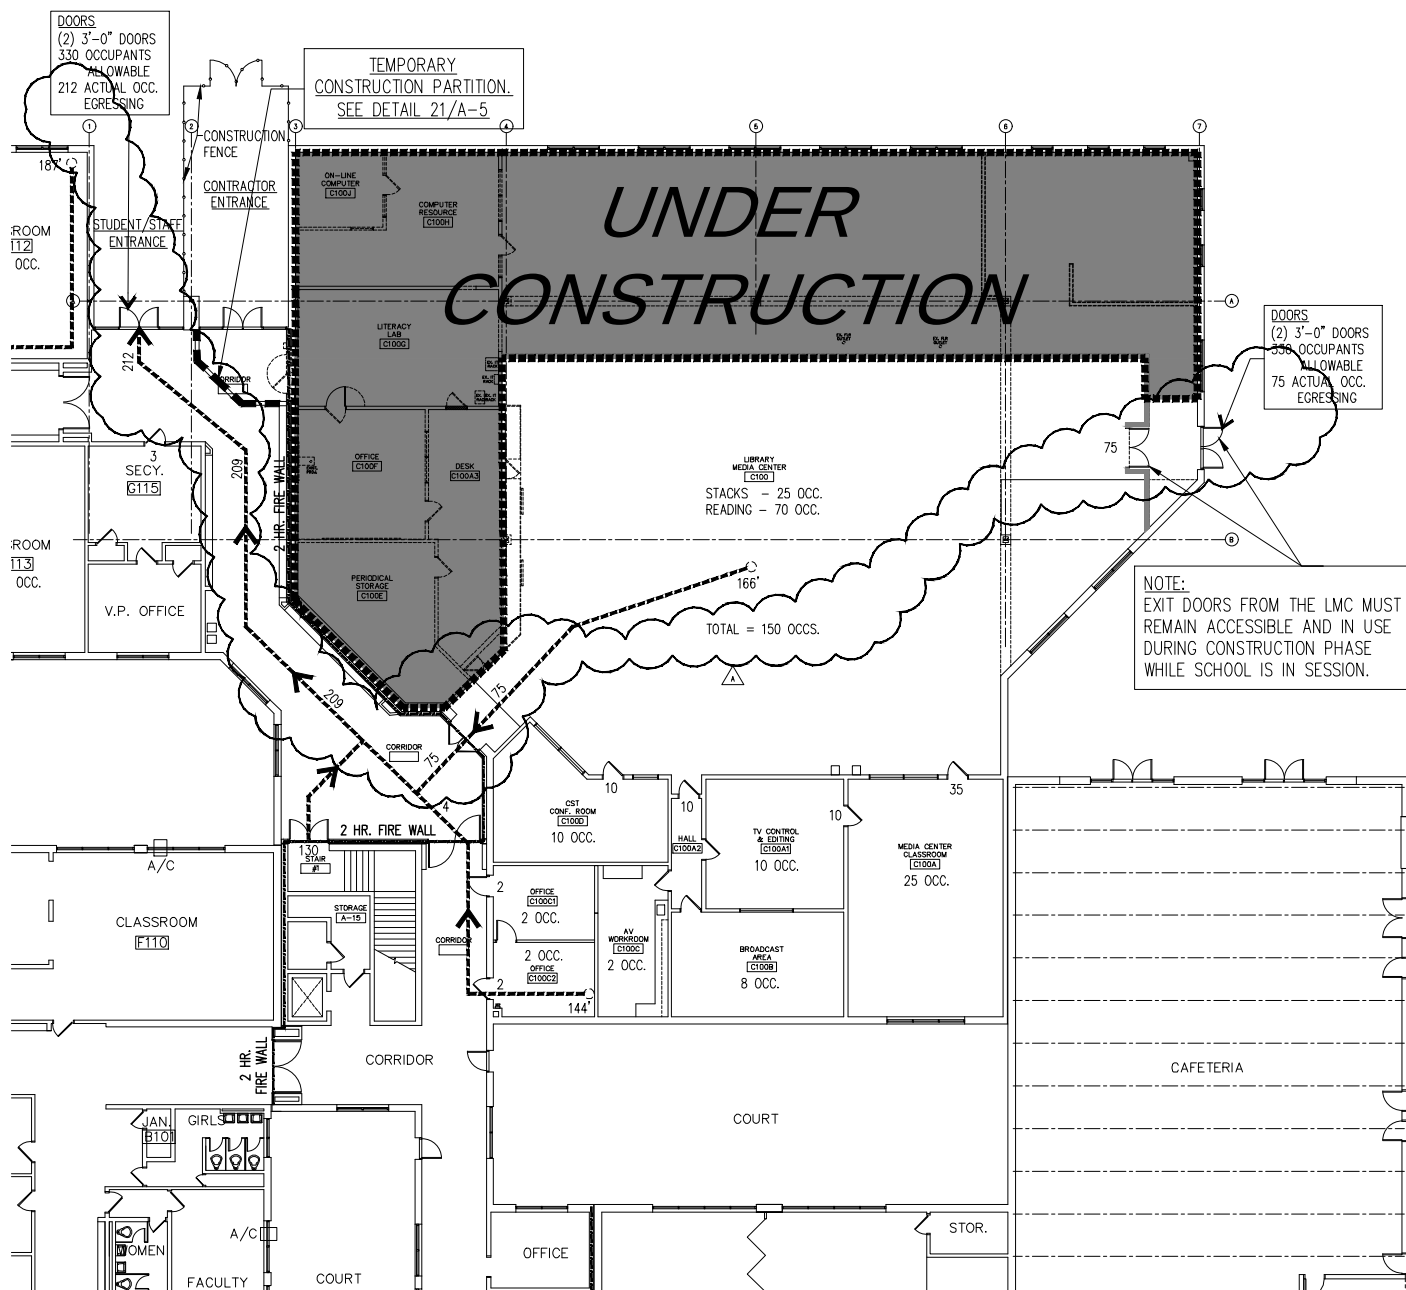

2 EGRESS FLOOR PLAN - BASE & ALTERNATE BID - CONSTRUCTION PHASE (DURING SCHOOL YEAR) - 4/28/25 THRU 6/20/25
A-0 SCALE: 1/16" = 1'-0"



**GARRISON
ARCHITECTS**

A Professional Corporation of Architects and Planners
713 CREEK ROAD, BELLMAWR, NEW JERSEY 08031 (856) 396-6200

PROJECT NAME:
HIGHLAND REGIONAL HIGH SCHOOL
2025 LMC NEW CORRIDOR &
CLASSROOMS RENOVATIONS

PROJECT NUMBER:
23-73


DATE: 01/09/25

ADM-1.02


MULHERN
and ASSOCIATES, Incorporated
321 South York Road
Hatboro, Pennsylvania 19040
Phone: (215) 293-9900
Fax: (215) 293-9214

ALL NOTES ON PLANS MAY NOT BE ON THIS SHEET
FOR ALL NOTES REFER TO NOTES ON M4.1

PRIOR TO BIDDING, MECHANICAL CONTRACTOR
TO VISIT SITE PER SPECIFICATION 15010
ALL WORK NEW U.N.O.
ALL WORK BASE BID U.N.O.

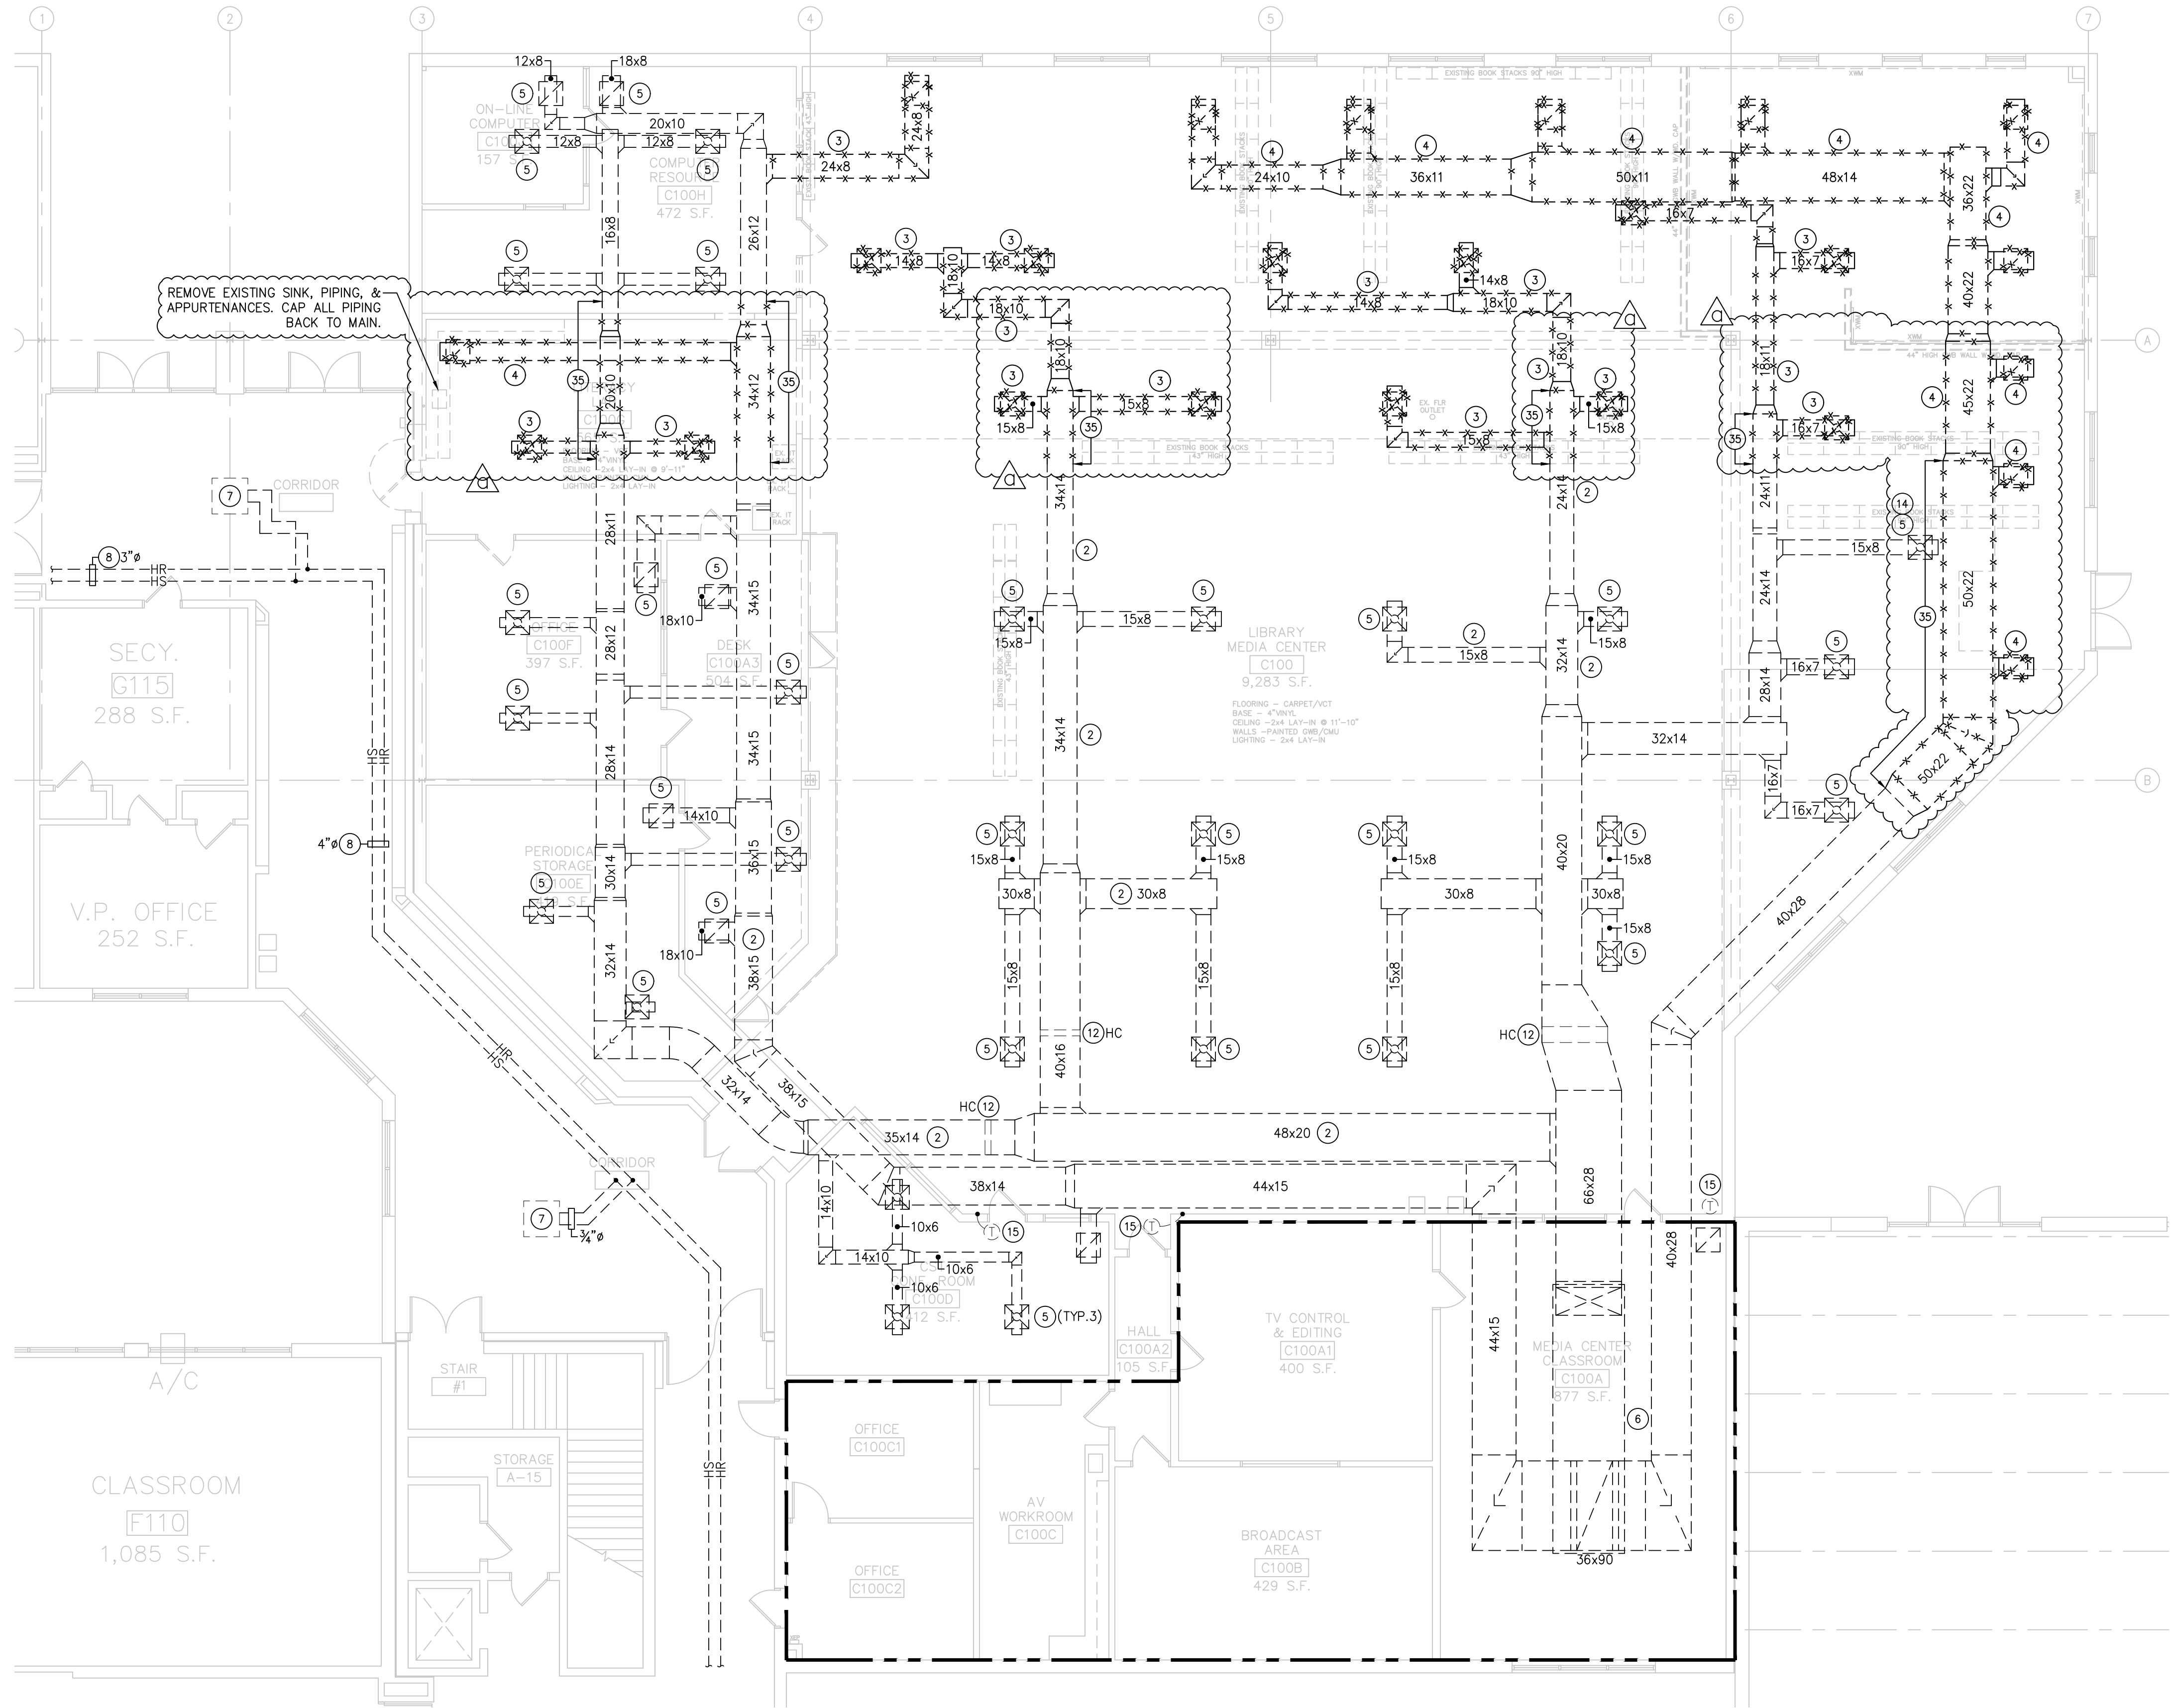

1 BASE BID
MECHANICAL DEMOLITION FLOOR PLAN
SCALE: 1/8" = 1'-0"

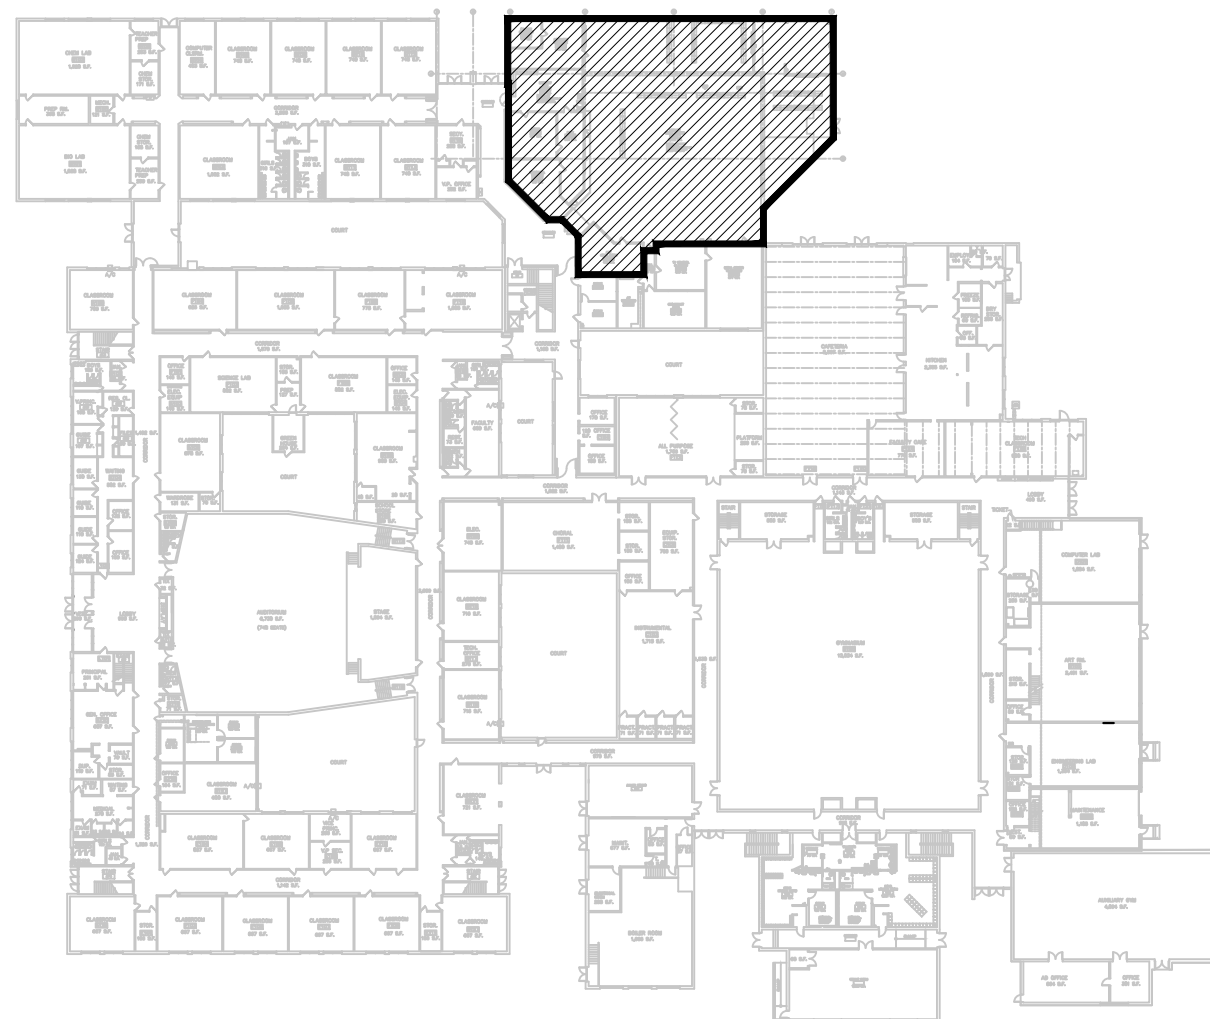

KEYPLAN

ISSUED FOR ADDENDUM #1: 01-09-25

GARRISON
ARCHITECTS
A Professional Corporation of Architects and Planners
713 CREEK ROAD, BELLMAW, NEW JERSEY 08001 (609) 396-5200

BLACK HORSE PIKE REGIONAL SCHOOL DISTRICT
HIGHLAND REGIONAL HIGH SCHOOL
2025 LMC NEW CORRIDOR & CLASSROOMS RENOVATIONS
450 ERIAL ROAD
BLACKWOOD, NEW JERSEY 08012


REVISIONS

A. ADDENDUM #1 01-09-25
B.
C.

Project No. 23-73
Date: 12-18-24
Scale: AS NOTED

BASE BID
MECHANICAL
DEMOLITION
FLOOR PLAN

M1.1

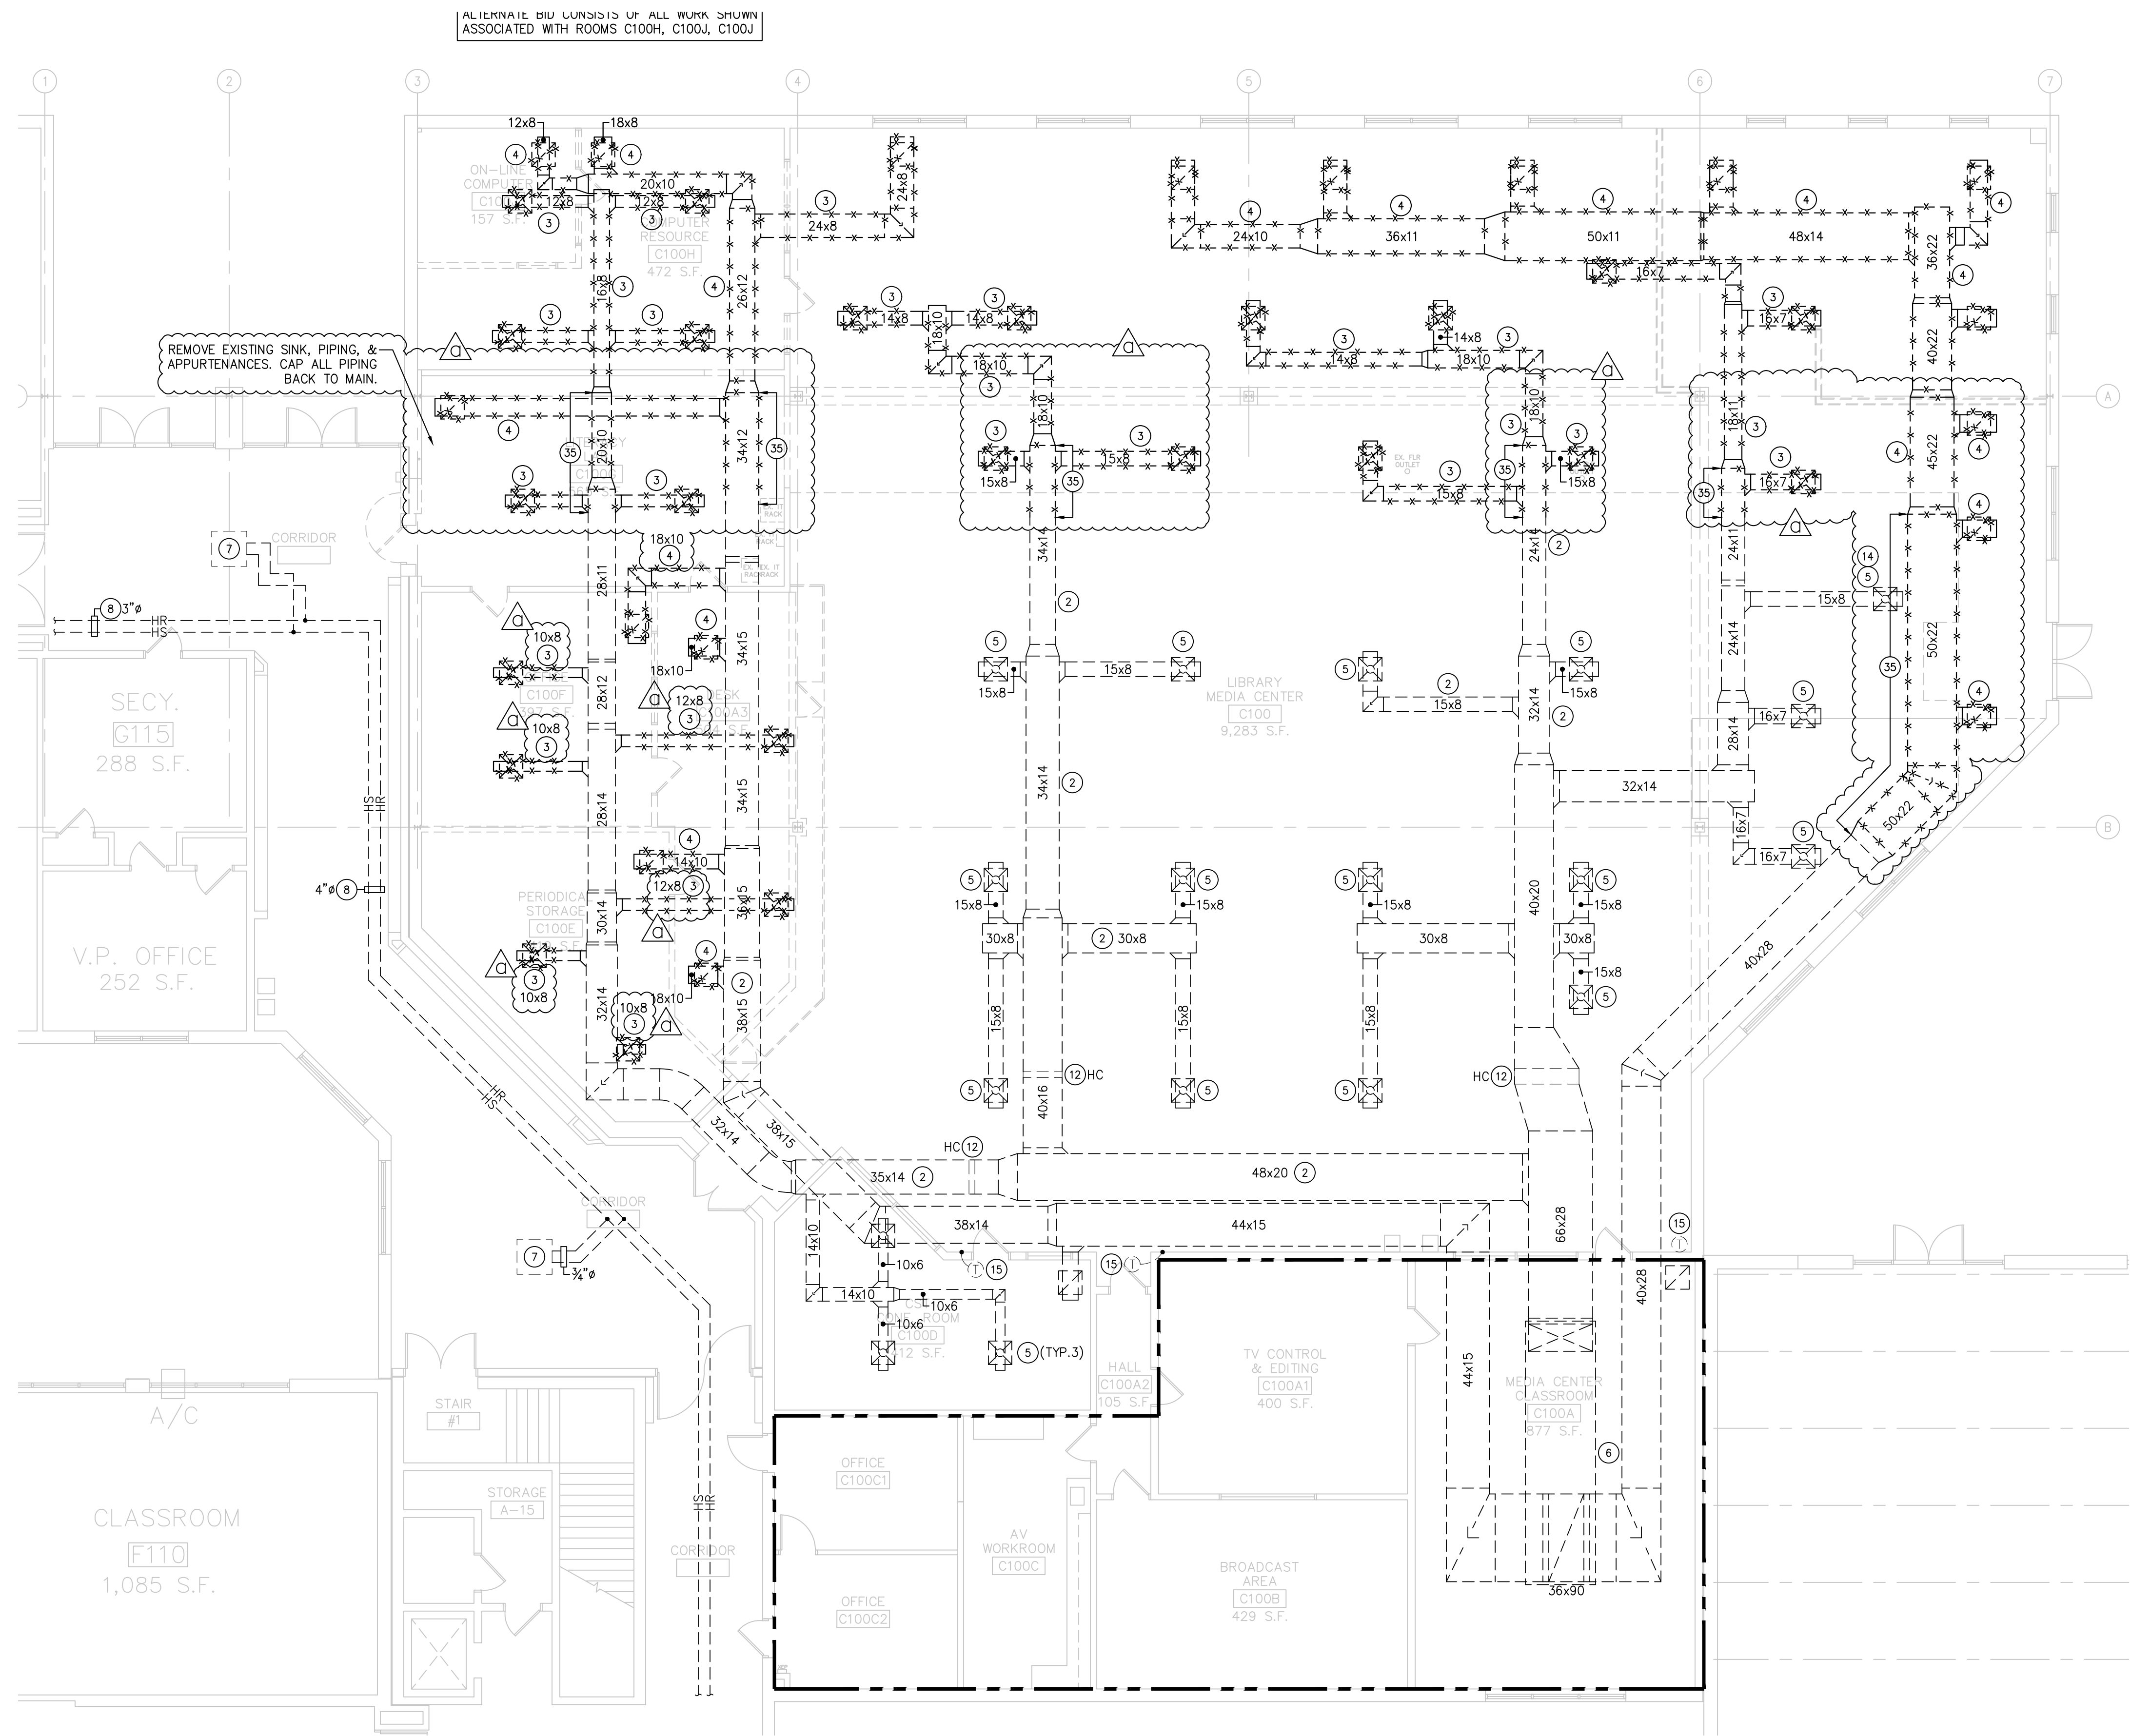


MULHERN
and ASSOCIATES, Incorporated
321 South York Road
Hatboro, Pennsylvania 19040
Phone: (215) 293-9900
Fax: (215) 293-9214

ALL NOTES ON PLANS MAY NOT BE ON THIS SHEET
FOR ALL NOTES REFER TO NOTES ON M4.1

PRIOR TO BIDDING, MECHANICAL CONTRACTOR
TO VISIT SITE PER SPECIFICATION 15010
ALL WORK NEW U.N.O.
ALL WORK BASE BID U.N.O.

GARRISON
ARCHITECTS
A Professional Corporation of Architects and Planners
713 CREEK ROAD, BELLMAW, NEW JERSEY 08001 (609) 396-5200

**BLACK HORSE PIKE REGIONAL SCHOOL DISTRICT
HIGHLAND REGIONAL HIGH SCHOOL
2025 LMC NEW CORRIDOR & CLASSROOMS RENOVATIONS
450 ERIAL ROAD
BLACKWOOD, NEW JERSEY 08012**

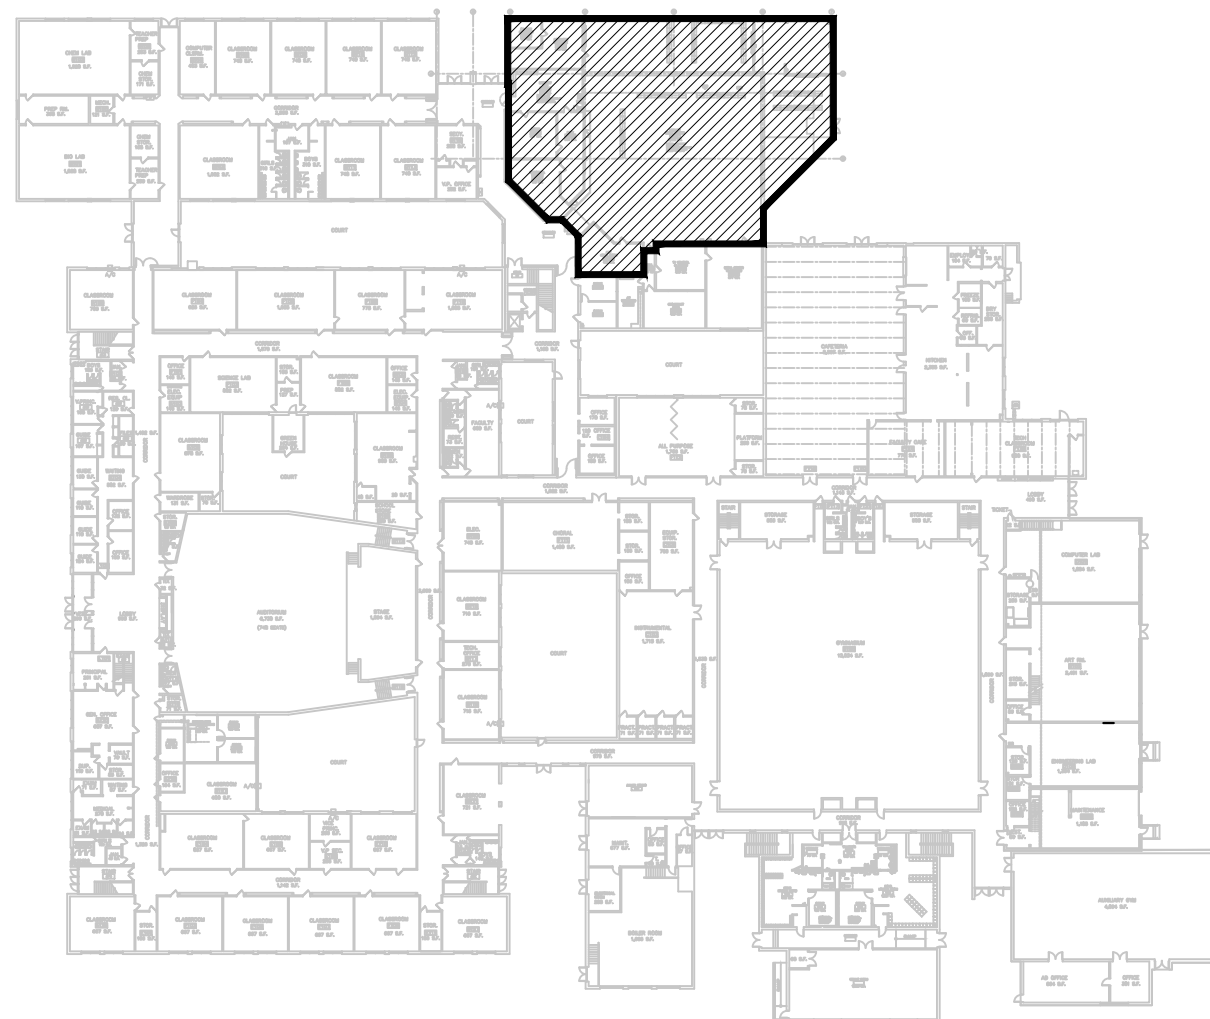

KEYPLAN


ISSUED FOR ADDENDUM #1: 01-09-25

REVISIONS


A. ADDENDUM #1 01-09-25
B.
C.

Project No. 23-73
Date: 12-18-24
Scale: AS NOTED

**ALTERNATE BID
MECHANICAL
DEMOLITION
FLOOR PLAN
M1.1A**

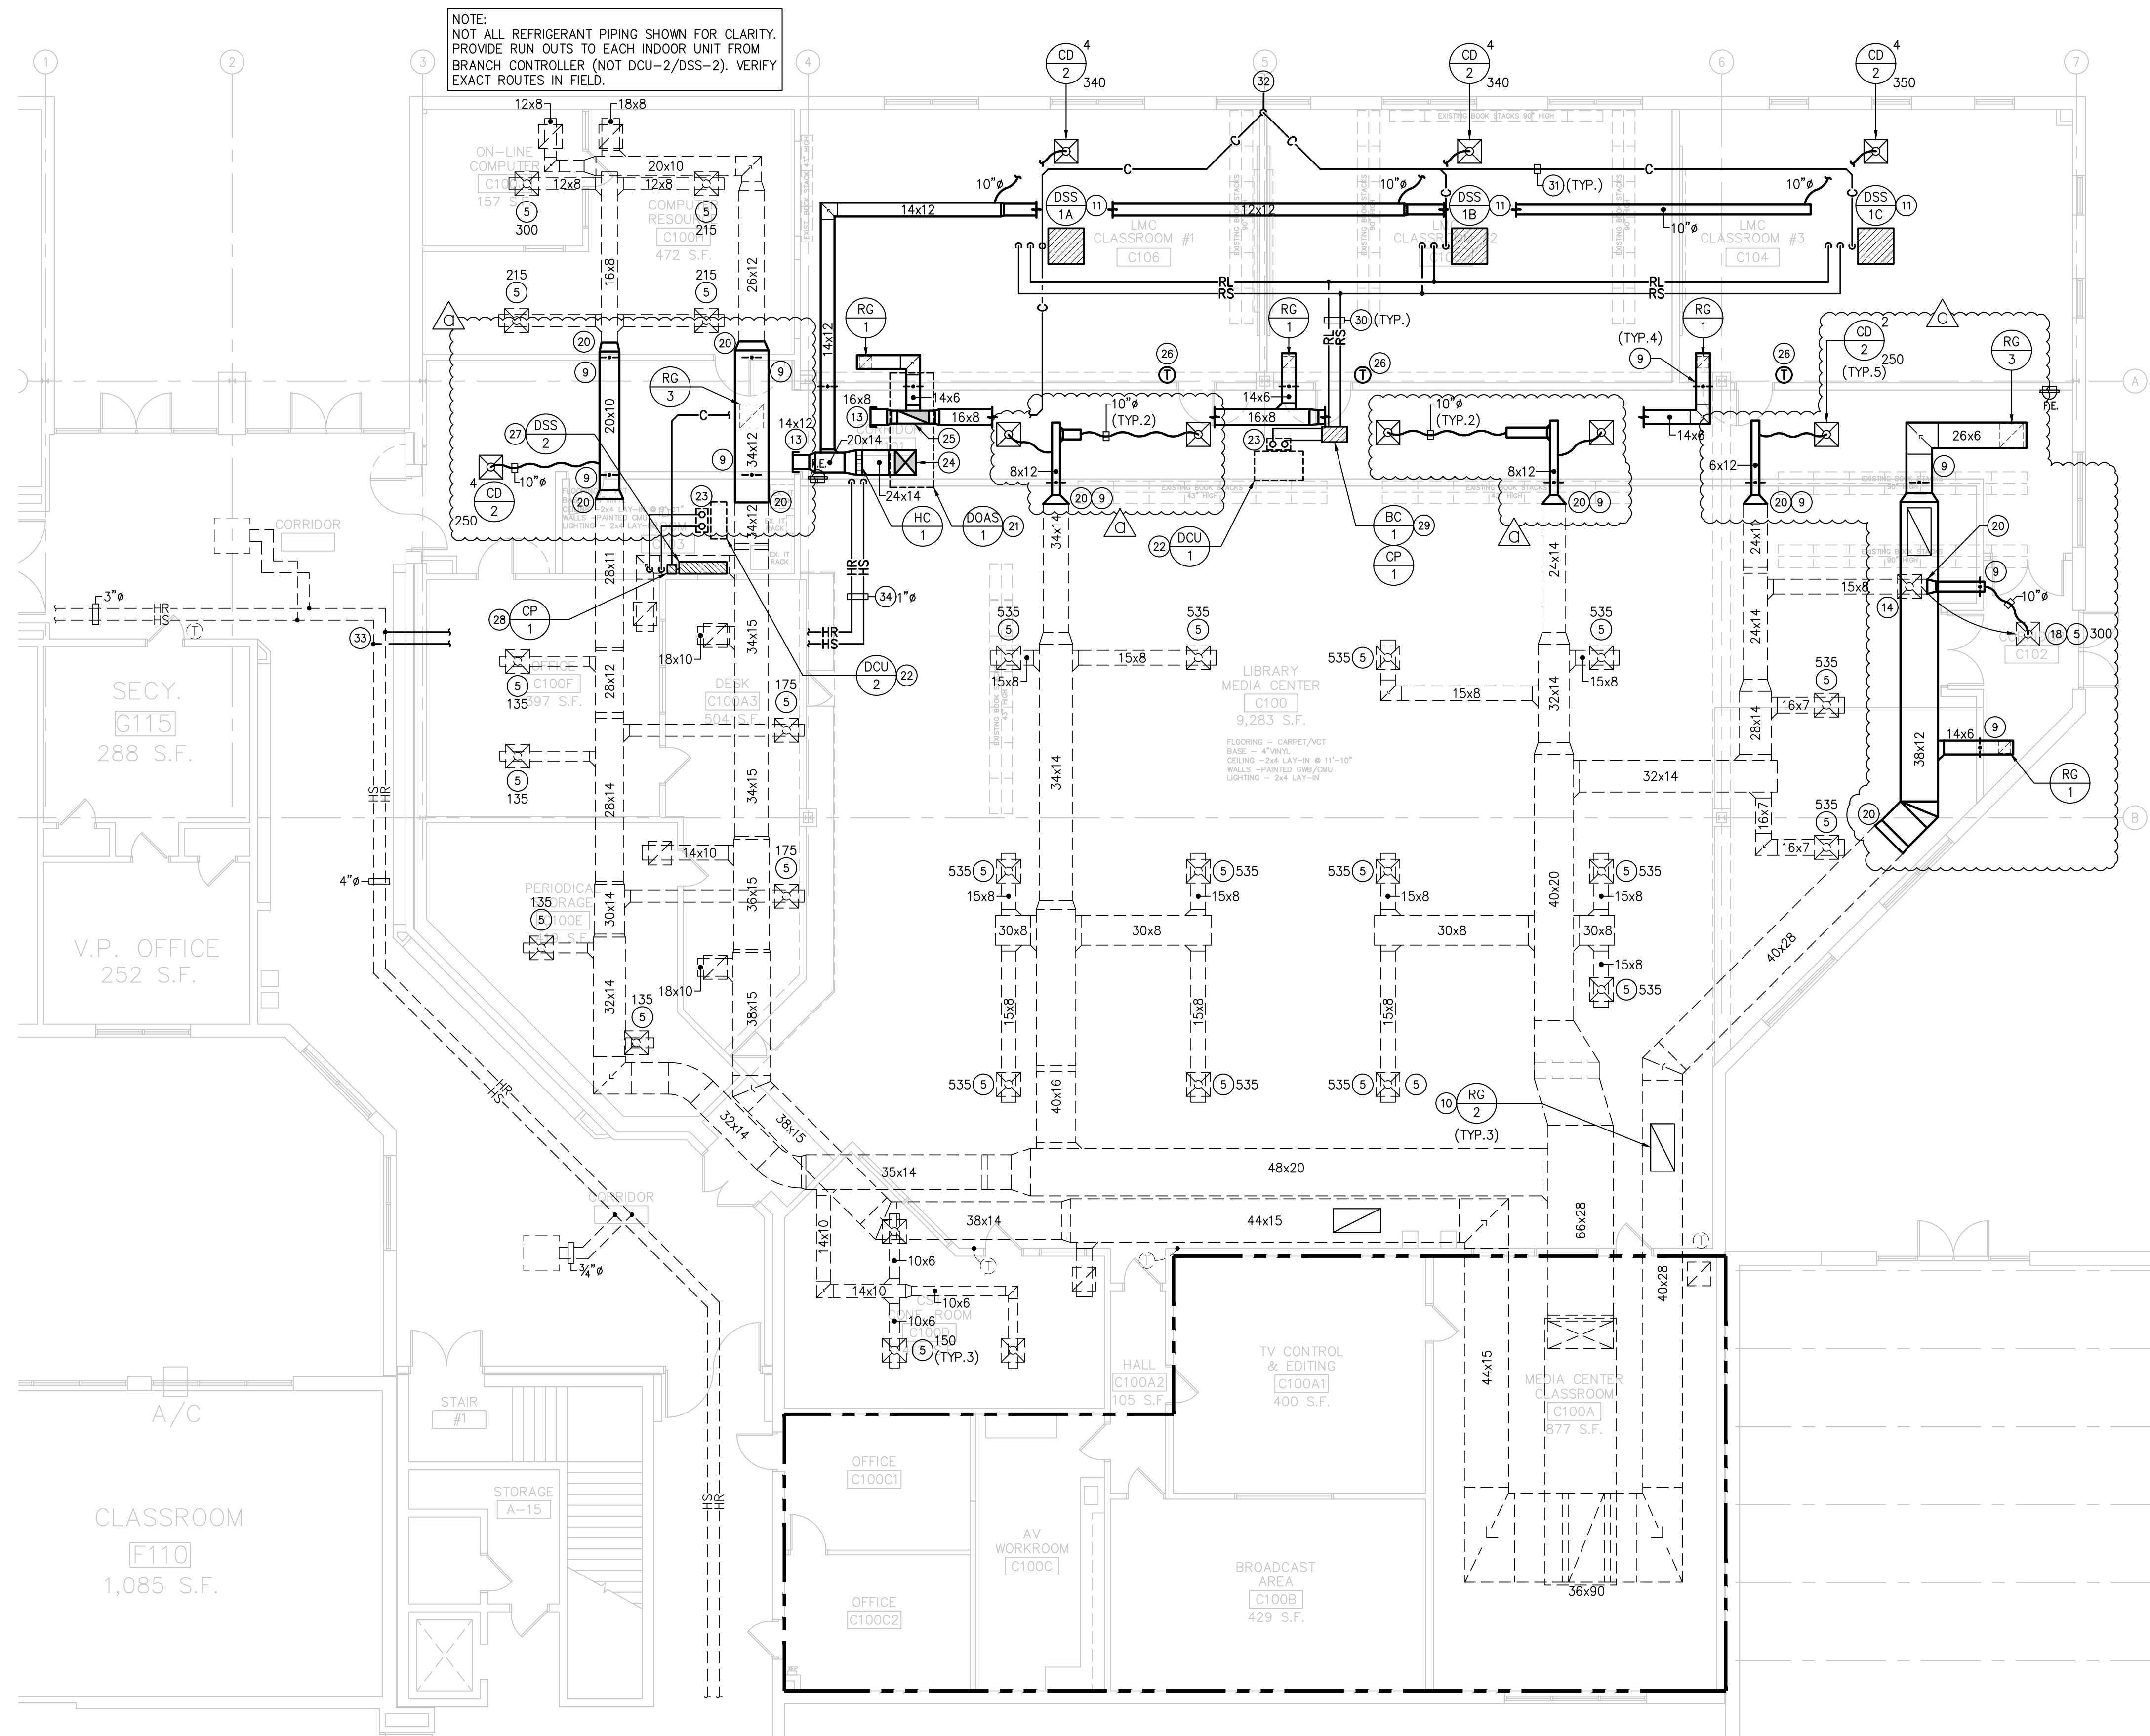

1 BASE BID MECHANICAL NEW WORK FLOOR PLAN
SCALE: 1/8" = 1'-0"

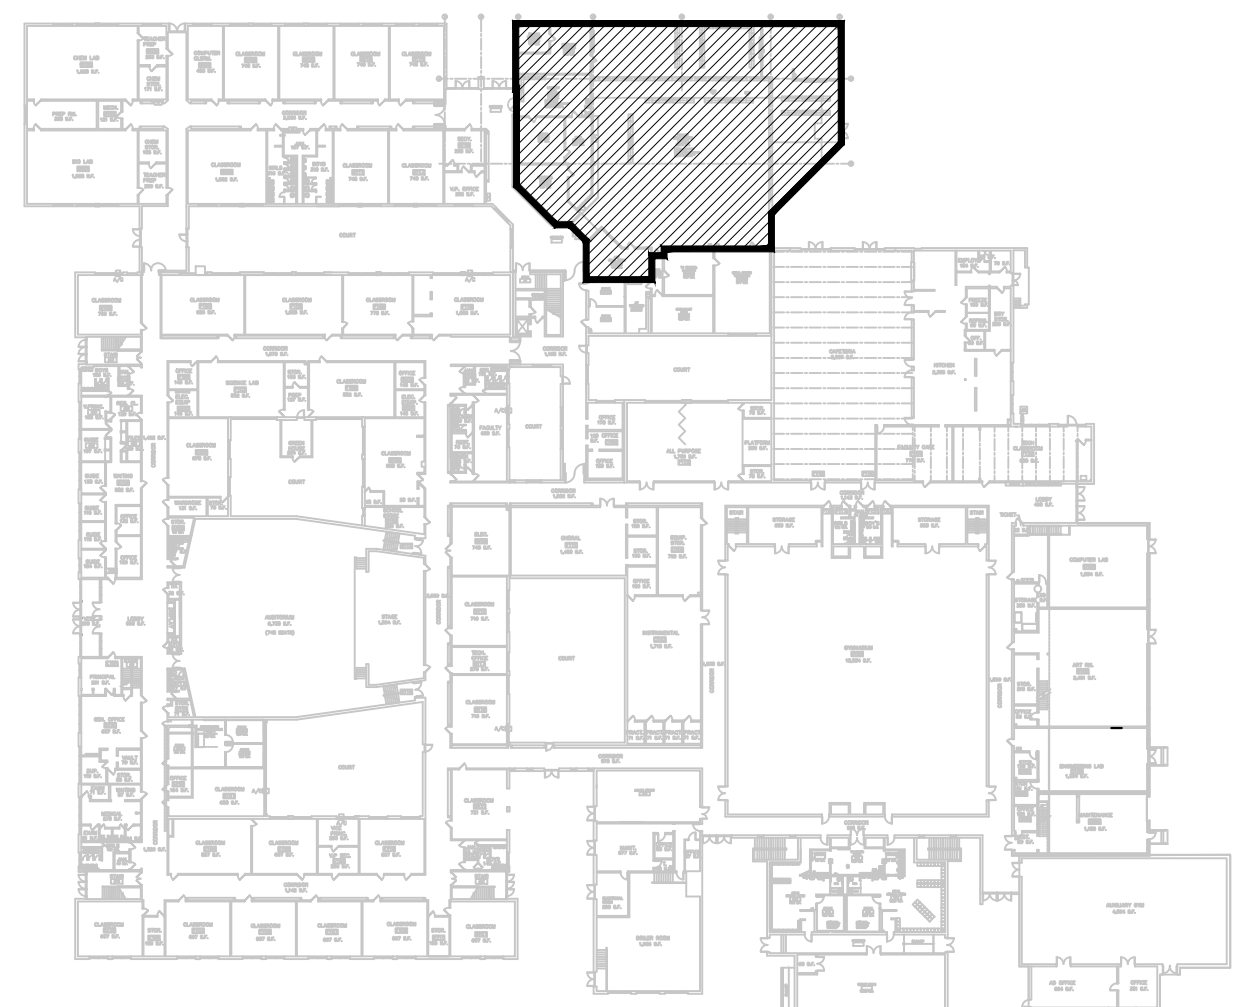

KEYPLAN
ISSUED FOR ADDENDUM #1: 01-09-25

MULHERN
and ASSOCIATES, Incorporated
321 South York Road
Hatboro, Pennsylvania 19040
Phone: (215) 293-9900
Fax: (215) 293-9214

ALL NOTES ON PLANS MAY NOT BE ON THIS SHEET
FOR ALL NOTES REFER TO NOTES ON M4.1

PRIOR TO BIDDING, MECHANICAL CONTRACTOR
TO VISIT SITE PER SPECIFICATION 15010
ALL WORK NEW U.N.O.
ALL WORK BASE BID U.N.O.


BLACK HORSE PIKE REGIONAL SCHOOL DISTRICT
HIGHLAND REGIONAL HIGH SCHOOL
2025 LMC NEW CORRIDOR & CLASSROOMS RENOVATIONS
450 ERIAL ROAD
BLACKWOOD, NEW JERSEY 08012

GARRISON
ARCHITECTS
A Professional Corporation of Architects and Planners
713 CREEK ROAD, BELLMAW, NEW JERSEY 08001 (609) 396-5200

REVISIONS	
A.	ADDENDUM #1 01-09-25
B.	
C.	

Project No. 23-73
Date: 12-18-24
Scale: AS NOTED

BASE BID MECHANICAL NEW WORK FLOOR PLAN
M2.1

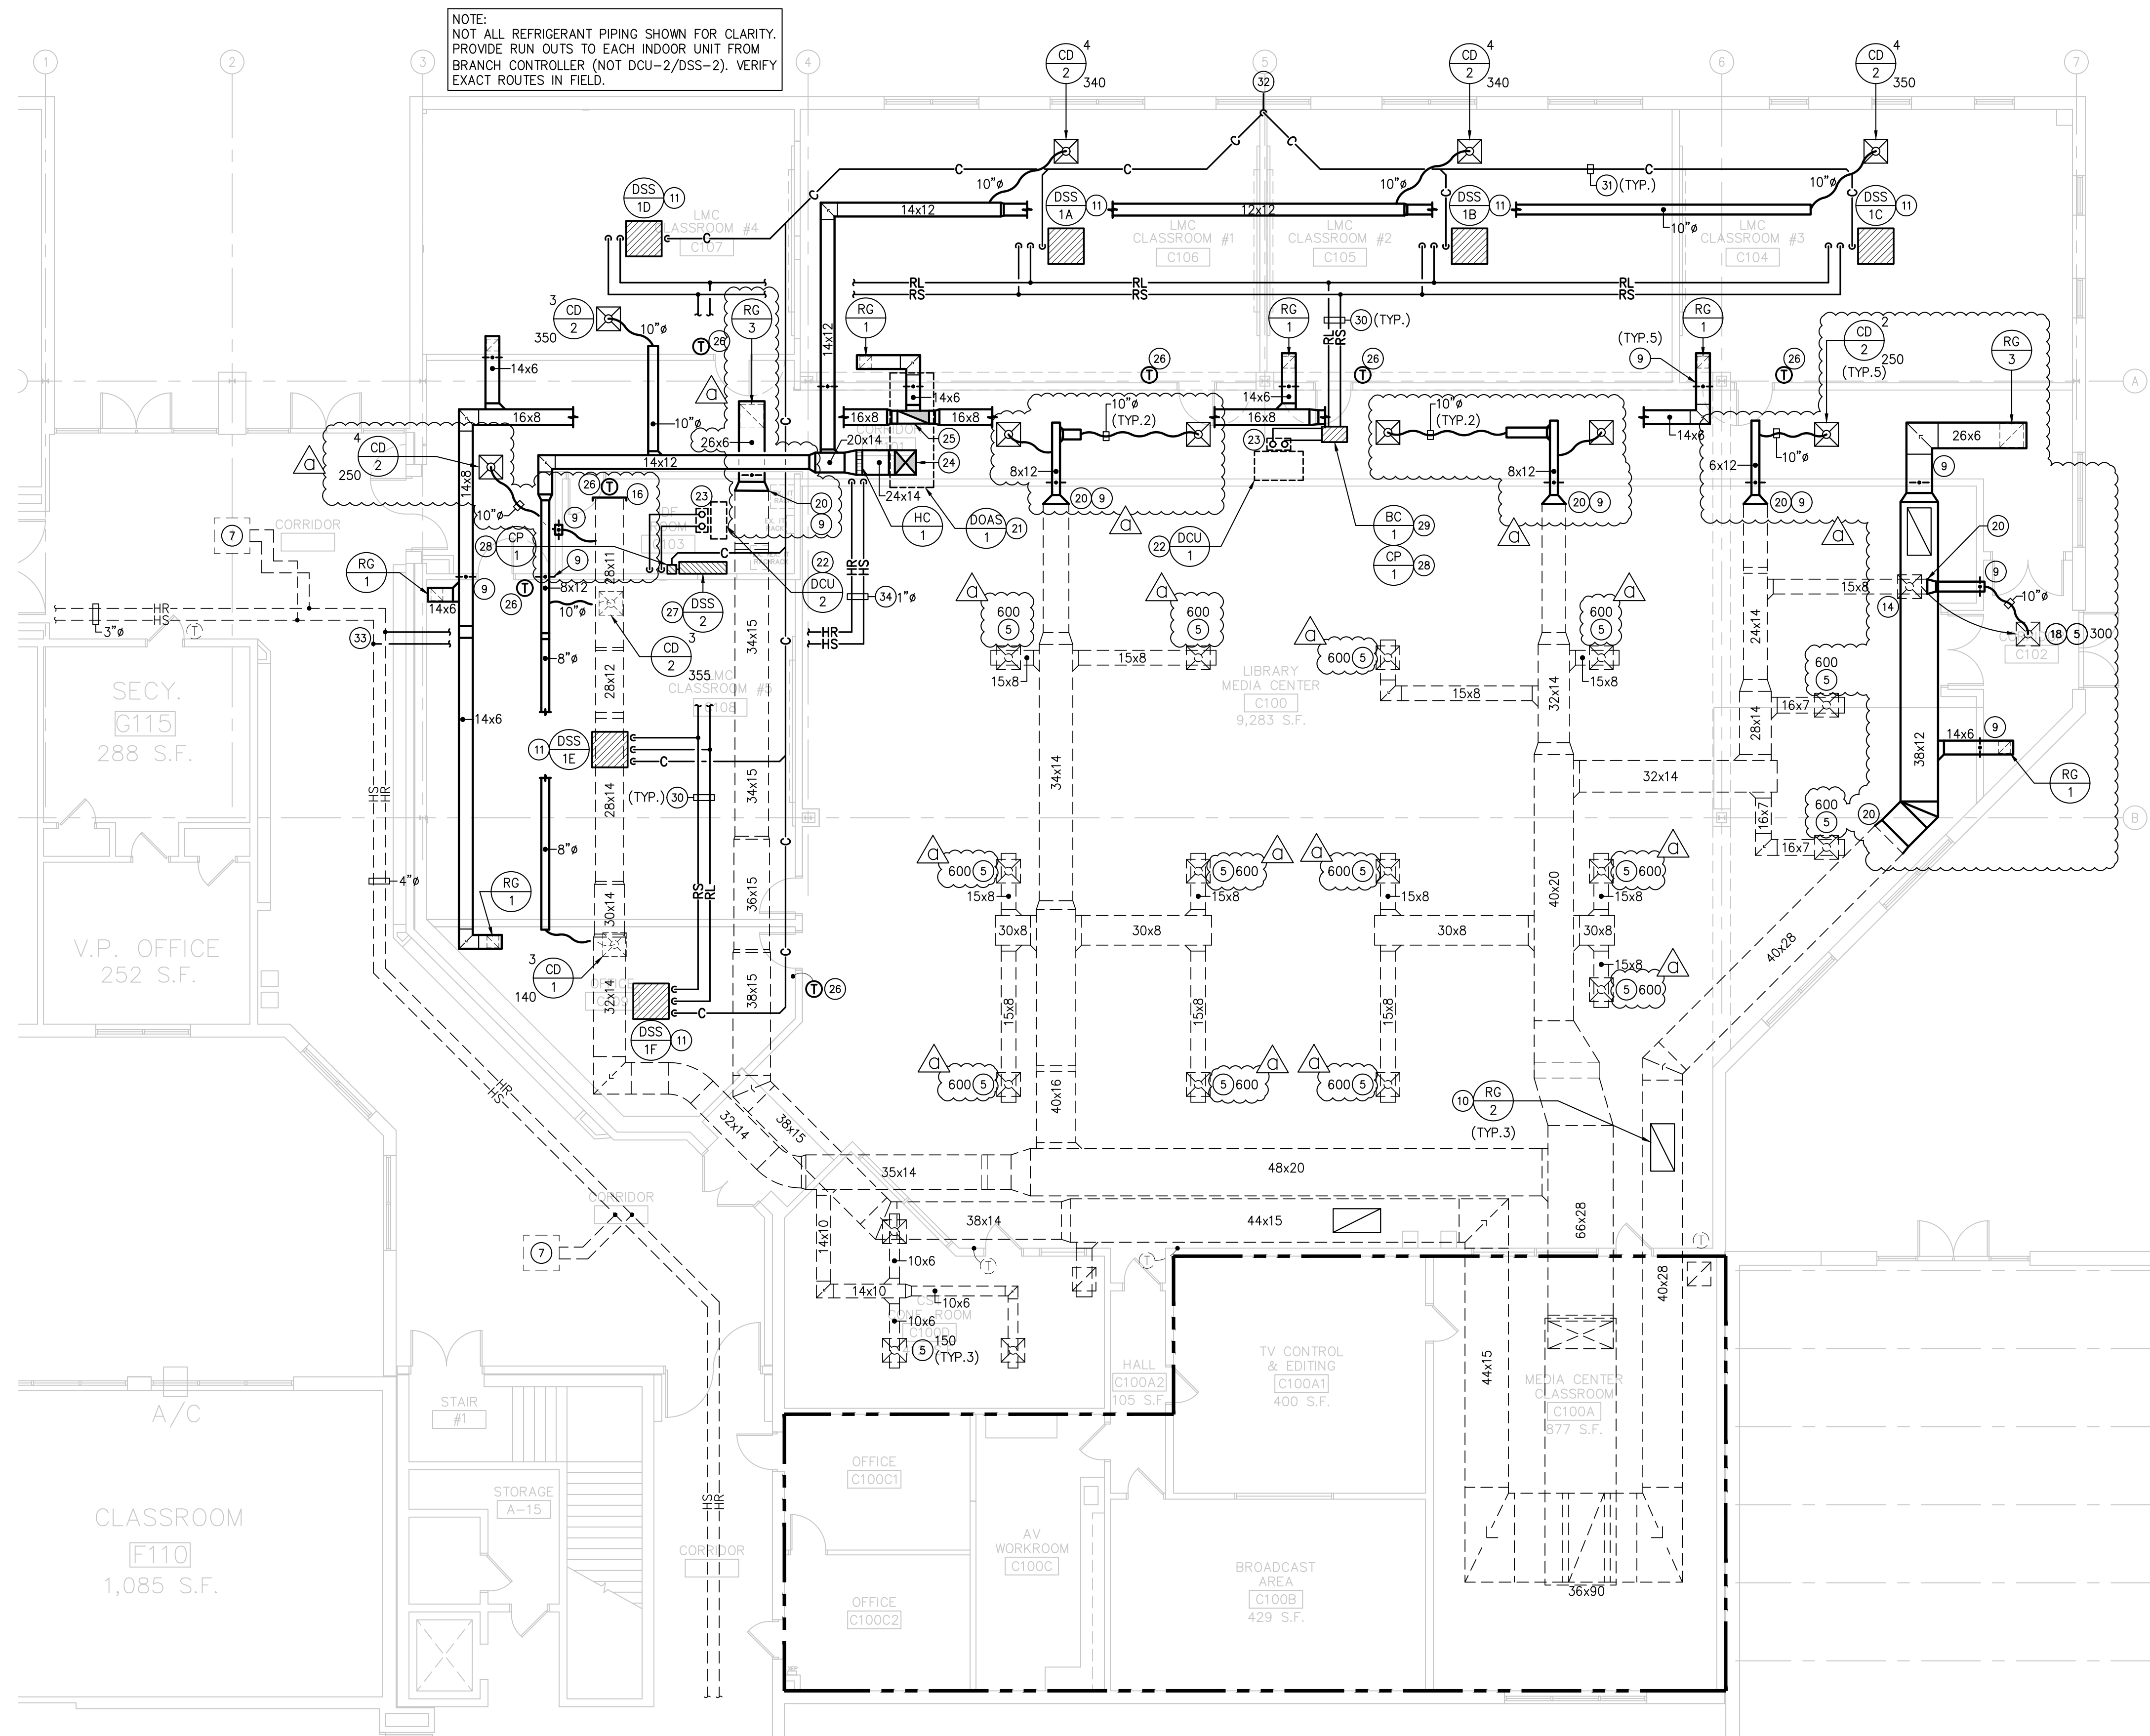


MULHERN
and ASSOCIATES, Incorporated
321 South York Road
Hatboro, Pennsylvania 19040
Phone: (215) 293-9900
Fax: (215) 293-9214

ALL NOTES ON PLANS MAY NOT BE ON THIS SHEET
FOR ALL NOTES REFER TO NOTES ON M4.1

PRIOR TO BIDDING, MECHANICAL CONTRACTOR
TO VISIT SITE PER SPECIFICATION 15010
ALL WORK NEW U.N.O.
ALL WORK BASE BID U.N.O.

1 **ALTERNATE BID
MECHANICAL NEW WORK FLOOR PLAN**
SCALE: 1/8" = 1'-0"

NOTE:
CONTRACTOR IS CAUTIONED, BASE BID WORK IS
SHOWN FOR CLARITY.
ALTERNATE BID CONSISTS OF ALL WORK SHOWN
ASSOCIATED WITH ROOMS C107, C108, & C109.

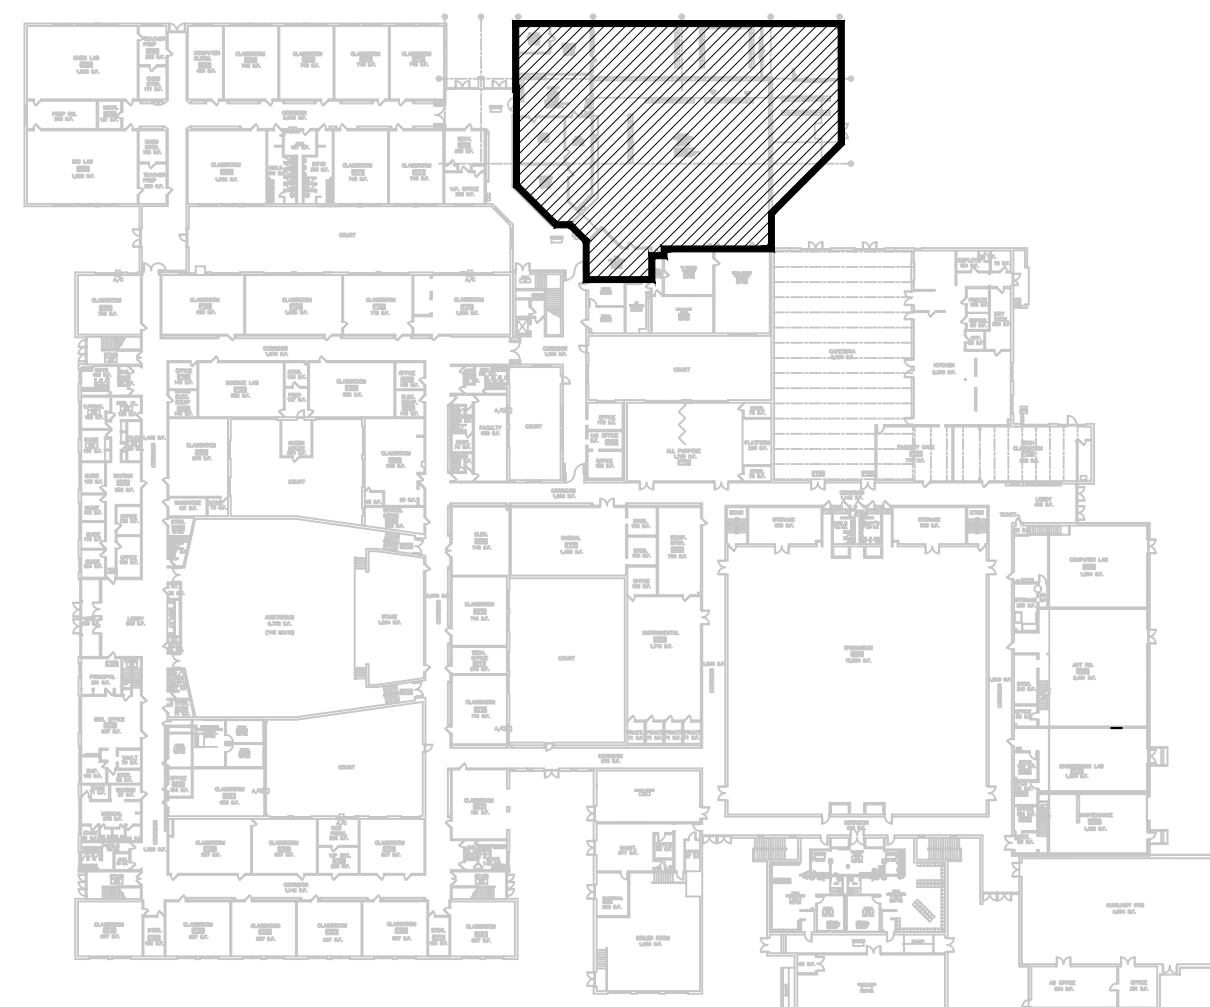

KEYPLAN

ISSUED FOR ADDENDUM #1: 01-09-25

**GARRISON
ARCHITECTS**
A Professional Corporation of Architects and Planners
713 CREEK ROAD, BELLMAWR, NEW JERSEY 08001 (609) 396-5200

**BLACK HORSE PIKE REGIONAL SCHOOL DISTRICT
HIGHLAND REGIONAL HIGH SCHOOL
2025 LMC NEW CORRIDOR & CLASSROOMS RENOVATIONS**
450 ERIAL ROAD
BLACKWOOD, NEW JERSEY 08012

REVISIONS

A. ADDENDUM #1 01-09-25
B.
C.

Project No. 23-73
Date: 12-18-24
Scale: AS NOTED

**ALTERNATE BID
MECHANICAL
NEW WORK
FLOOR PLAN
M2.1A**